


BOILER DETAILING

SCALE: 1"=1.0'

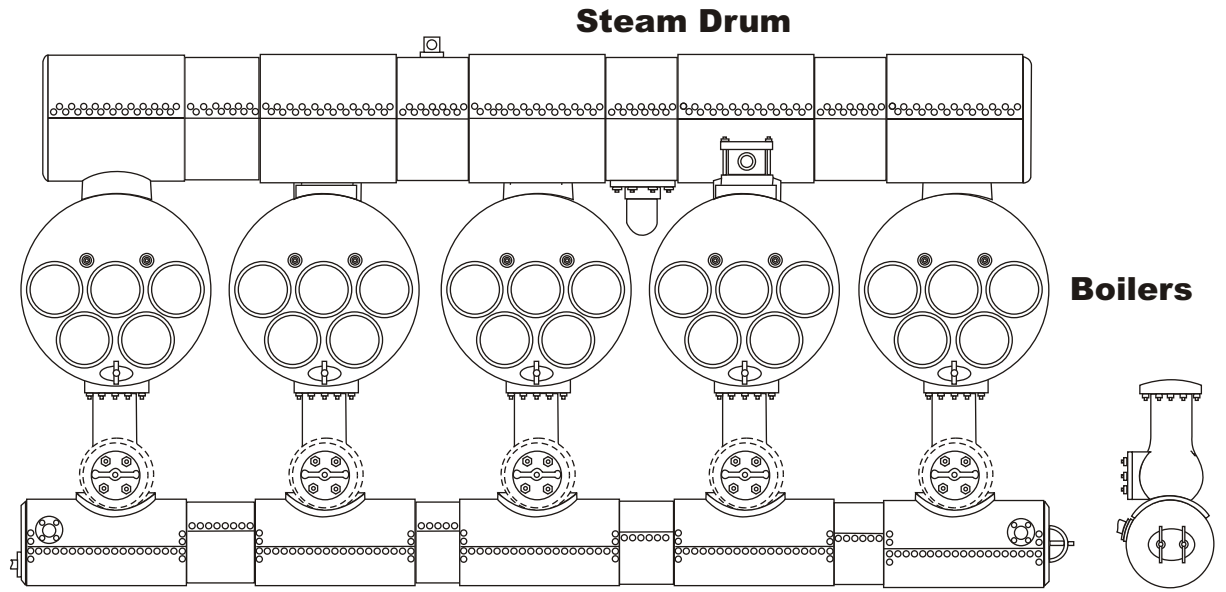


Mud Drum

lateral elevation - forward

SCALE: 1"=1.0'

(AS BUILT)

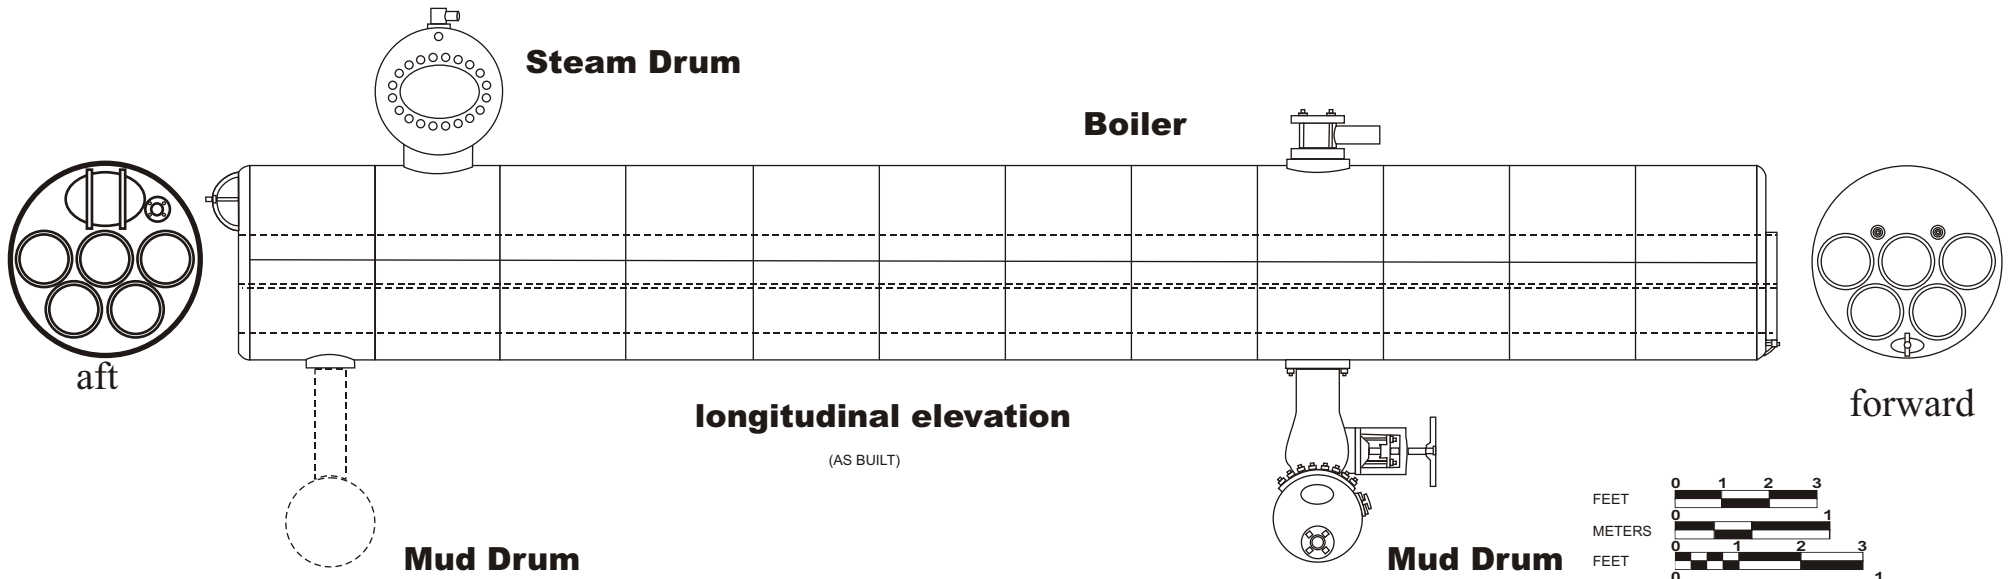

Steam Drum

Boiler

longitudinal elevation

(AS BUILT)

Mud Drum

Mud Drum

